

PFO1/4B PALUSTRINE FORESTED, BROAD LEAVED DECIDUOUS/
NEEDLE LEAVED EVERGREEN, SATURATED


- 1 WETLAND AREA PHOTO (7-31-19)
ORIENTATION & DIRECTION

 TALL STAKE


AS-BUILT WETLAND DISTURBANCE AREA
(2,345 SQ.FT.)

MATERIAL	DIAMETER	LENGTH	SLOPE	INV. IN	INV. OUT	EMBEDDED
HPDE	24"	30'	1%	297.5	297.2	6"

MATERIAL	DIAMETER	LENGTH	SLOPE	INV. IN	INV. OUT	EMBEDDED
HPDE	24"	30'	2%	297.8	297.2	6"

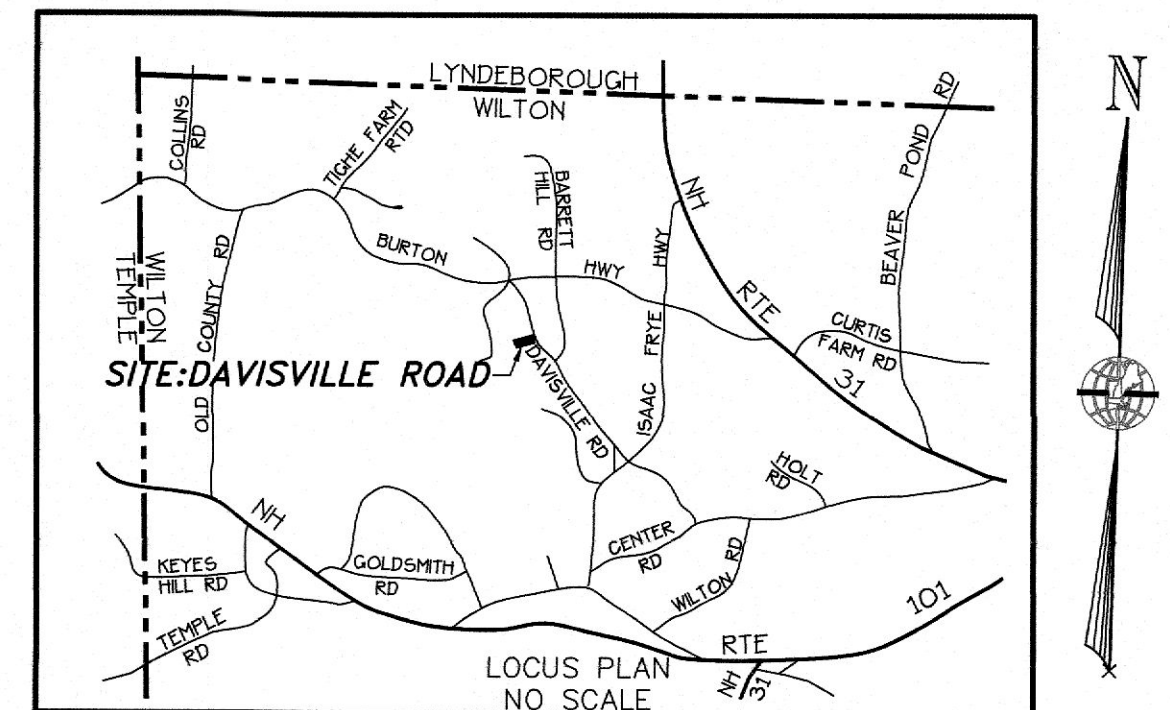

SUBDIVISION PLAN OF LAND PHILIP GODLEY II +
ANNE M. GODLEY WILTON, N.H.
SCALE: 1"=200', OCT. 8, 1980, BY THOMAS F. MORAN INC.

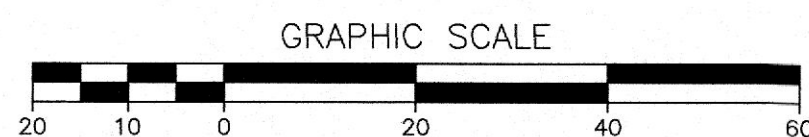


REV.	DATE	DESCRIPTION	C/O	DR	CK

Jun 06, 2025 - 10:07am DAH
H: \mls_wp\10665\10665_A-58-2A.dwg

CHRIS BROWN
WILTON, NEW HAMPSHIRE

JULY 6, 2025

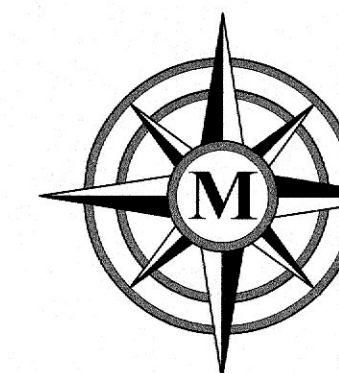

MERIDIAN
LAND SERVICES, INC.

ENGINEERING | SURVEYING | PERMITTING
SOIL & WETLAND MAPPING | SEPTIC DESIGN

31 OLD NASHUA ROAD, AMHERST, NH 03031 TEL. 603-673-1441
MERIDIANLANDSERVICES.COM FAX 603-673-1584

FILE:10665_A-58-2A.dwg PROJECT NO. 10665.01 SHEET NO. 1 OF 1